DATE: 09/03/98 TIME: 11:58:16
DESIGN FILE: I:\ligo\site1\ce\wac023.dgz

This document and the design it covers are the property of PARSONS. They are loaned only with the borrower's expressed written agreement that they will not be reproduced, copied, loaned, exhibited, or used in any other way, except by written consent from PARSONS to the borrower.

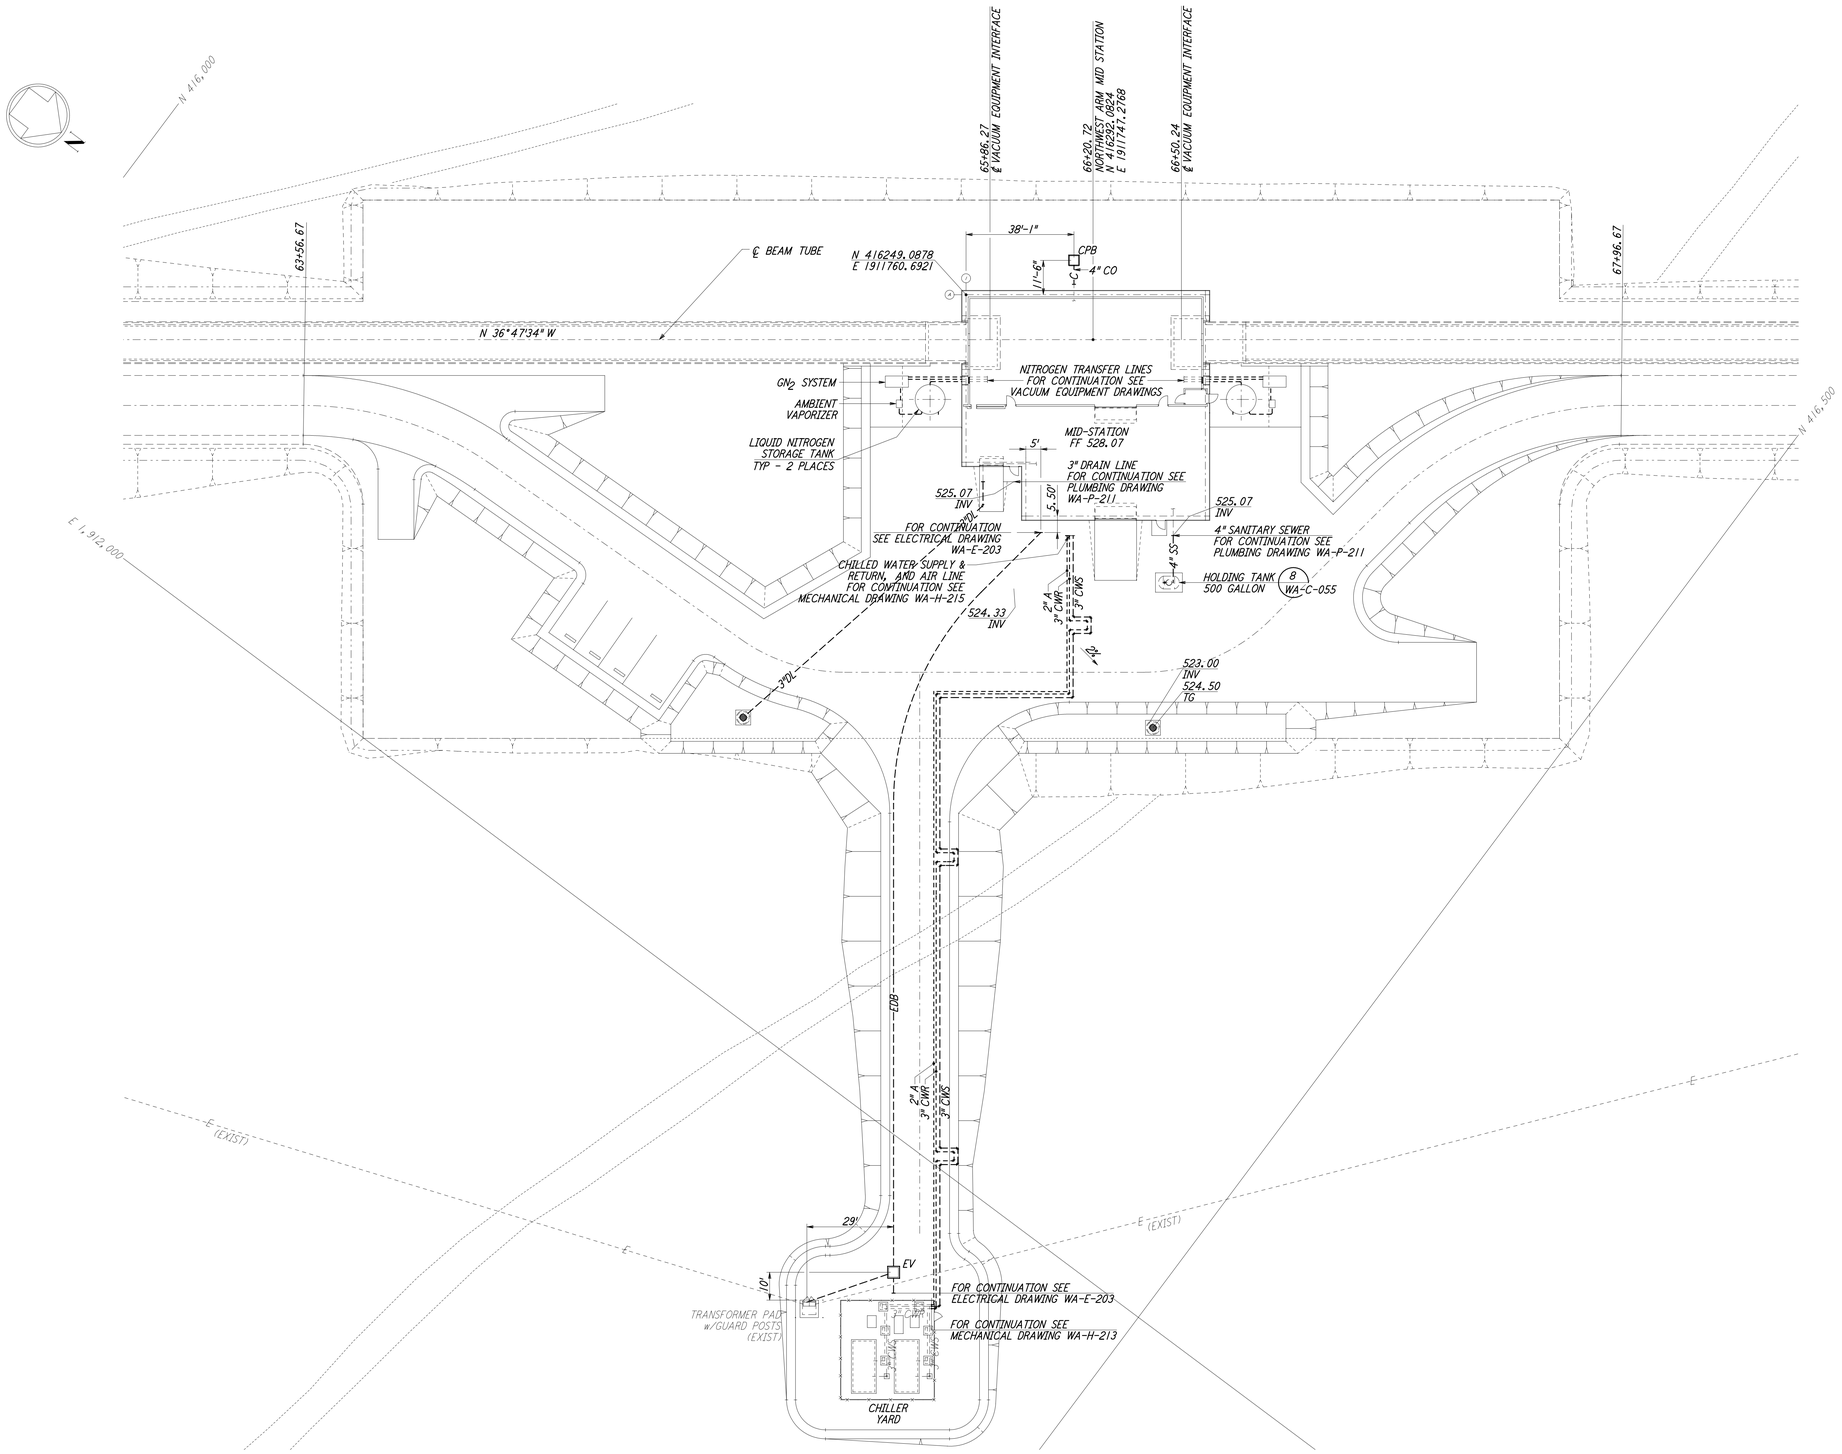

NOTES:

1. SEE SHEET WA-C-002 FOR GENERAL NOTES, LEGEND AND ABBREVIATIONS.

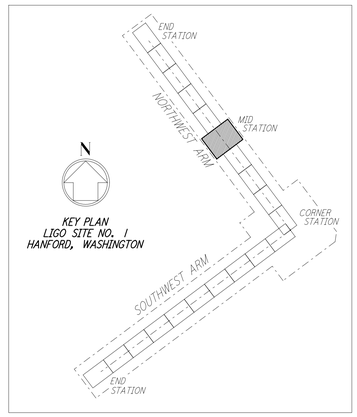

GRAPHIC SCALE
0 20 40 60 80
SCALE: 1" = 20'

LIGO-D960214-01-O

REFERENCES		REVISIONS							
		1	5/15/98	WRB					ISSUED FOR AS-BUILT
DRAWING NO.	DESCRIPTION	NO.	DATE	BY	CHKD	ENGR	PROJ		DESCRIPTION

FOR CONSTRUCTION

DRAWN	WRB	9/28/95
CHECKED	ML	7/9/96
ENGINEER	JB	7/9/96
PROJ	MDW	7/9/96

AS-BUILT DRAWINGS

PARSONS
100 WEST WALNUT STREET
PASADENA, CALIFORNIA

LIGO
CALIFORNIA INSTITUTE OF TECHNOLOGY
MASSACHUSETTS INSTITUTE OF TECHNOLOGY

LASER INTERFEROMETER
GRAVITATIONAL-WAVE OBSERVATORY
SITE NO. 1 - HANFORD, WASHINGTON

TITLE
CIVIL
NORTHWEST ARM
MID-STATION
UTILITY PLAN

SCALE	CONTRACT NUMBER	PROJECT NUMBER
1" = 20'	PP150969	8094

SHEET NUMBER: WA-C-023
REVISIONS: 1

LIGOWAF3.BDR